



**Proposed Amendments**

**Chesapeake Bay Preservation Areas**

**Fairfax County, Virginia**

July 10, 2006

# MAPS OF PROPOSED AMENDMENTS TO CHESAPEAKE BAY PRESERVATION AREAS

REVISIONS TO RPAs and RMAs ARE SHOWN IN RED

July 10, 2006

This set of maps provides a delineation of Chesapeake Bay Preservation Areas (Resource Protection Areas and Resource Management areas) as set forth in Section 118-1-7 of Chapter 118 (Chesapeake Bay Preservation Ordinance) of the *Code of the County of Fairfax, Virginia* adopted by the Board of Supervisors on July 7, 2003 (effective November 18, 2003). Where RPA and RMA boundaries on the adopted map differ from boundaries as determined from the text of the Ordinance, the text shall govern.

## LEGEND

### Resource Protection Areas (RPAs)

1993 RPAs –RPAs mapped pursuant to the Chesapeake Bay Preservation Ordinance adopted March 22, 1993 (1)



2003 RPAs –Additional RPAs mapped pursuant to the Chesapeake Bay Preservation Ordinance adopted July 7, 2003 (2)



2003 RPAs –Additional RPAs mapped pursuant to the Chesapeake Bay Preservation Ordinance adopted July 7, 2003, for perennial streams added to the map in 2005 (3) or later (7)



### Resource Management Areas (RMAs) (4)



### Detailed RPA field delineation approved for this site (6)



### Date RPA added to the map after 2005 (7)



### Water bodies with perennial flow (5)

Streams, Rivers  
Manmade Channels



Lakes, Ponds



### Non-perennial water bodies

Streams, Rivers



Lakes, Ponds




### Stormwater Sewer System

Pipes, Culverts



## Notes:

- (1) RPAs originally mapped pursuant to the Chesapeake Bay Preservation Ordinance adopted by the Fairfax County Board of Supervisors on March 22, 1993 (effective July 1, 1993) and revised on March 21, 1994.
- (2) Additional RPAs mapped pursuant to the Chesapeake Bay Preservation Ordinance adopted by the Fairfax County Board of Supervisors on July 7, 2003 (effective November 18, 2003).
- (3) Additional RPAs mapped pursuant to the Chesapeake Bay Preservation Ordinance adopted by the Fairfax County Board of Supervisors on July 7, 2003 (effective November 18, 2003) for perennial streams added to the map on July 11, 2005 (effective July 12, 2005).
- (4) RMAs include any area that is not designated as an RPA.
- (5) Upstream limits of perennial streams were identified during stream mapping field surveys conducted by the Department of Public Works and Environmental Services from 2002 through 2003. Additional field surveys were conducted in 2004 that resulted in revisions to the upstream limits of some streams. Perennial streams added to the map after the last general update of the map in 2005 are notated with the date the streams and their associated RPAs were added to the map (effective date).
- (6) The approved RPA boundary delineation should be consulted for the location of the RPA boundary on these sites. Approved RPA boundary delineations are on file with the Department of Public Works and Environmental Services. They are available for review at the Plan and Document Control Counter located on the 5<sup>th</sup> floor of the Herrity Building at 12055 Government Center Parkway, Fairfax, Virginia 22035
- (7) RPAs added to the map after the last general updated of the map in 2005 are depicted on the map with the symbol for 2003 RPAs (revised) and further notated with the date the RPAs were added to the map (effective date).

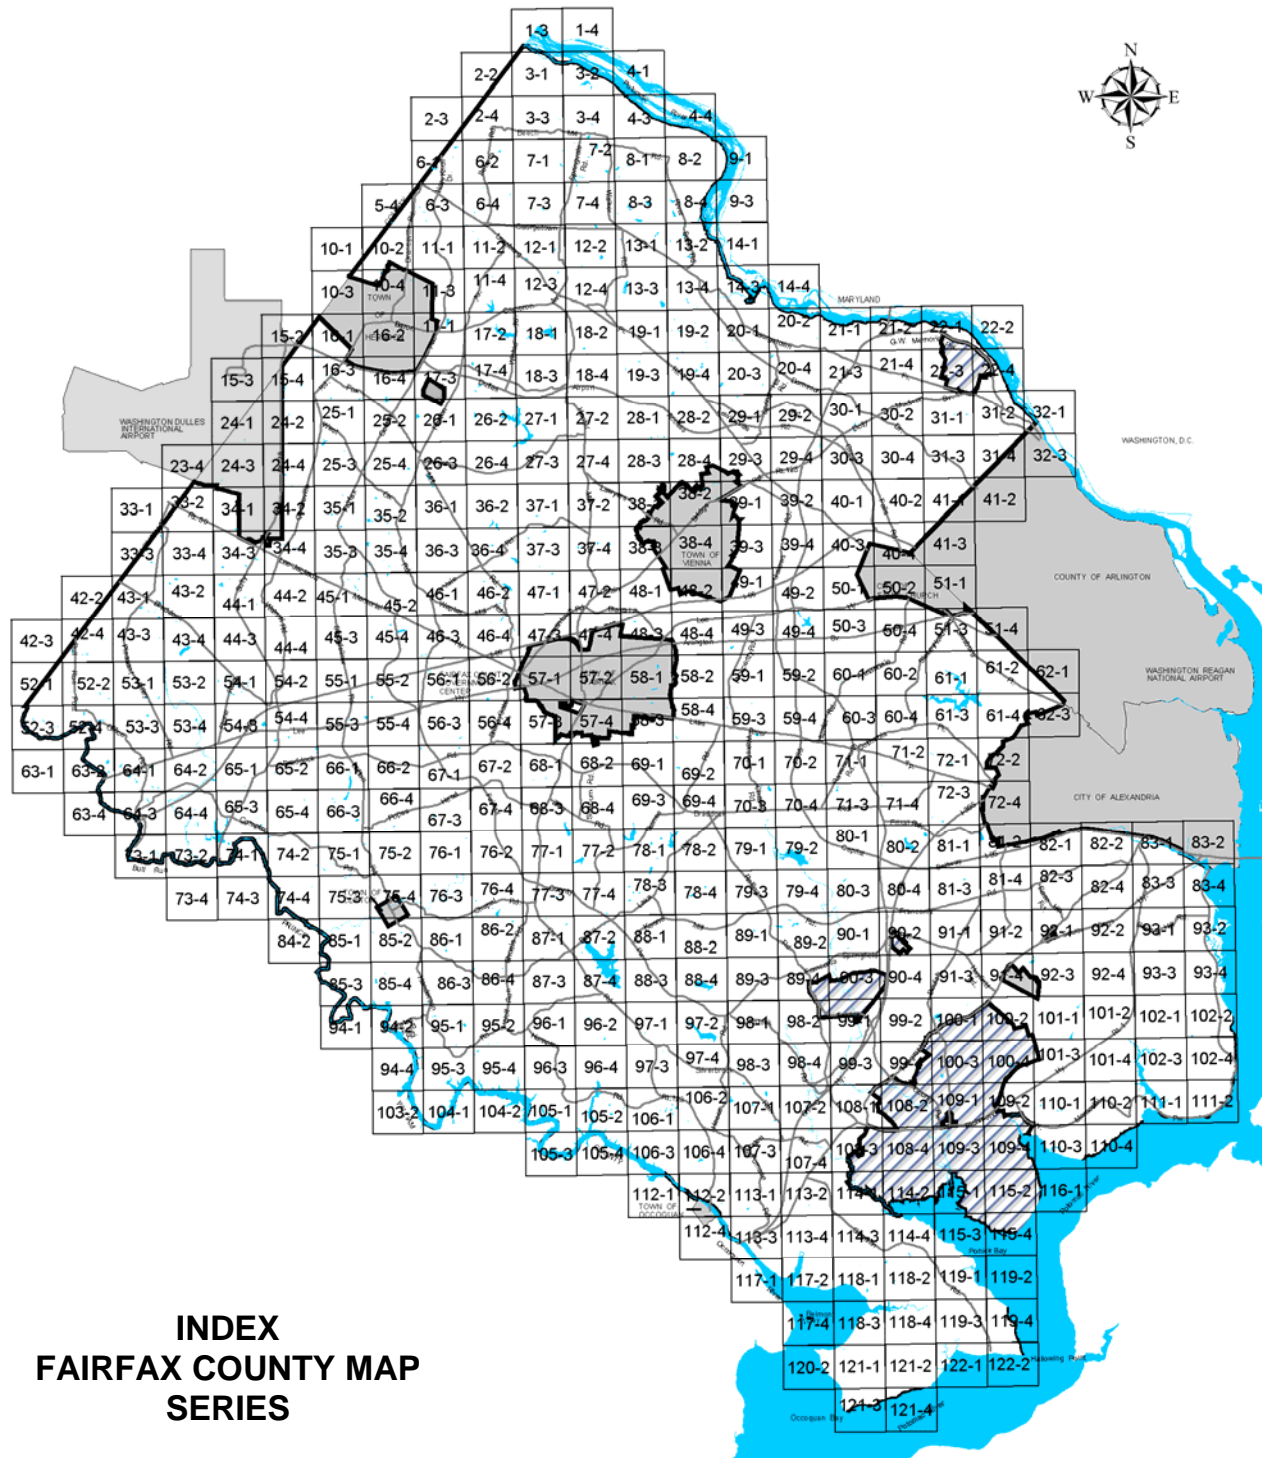

# **INDEX** **FAIRFAX COUNTY MAP** **SERIES**